


I CERTIFY TO THE BEST OF MY KNOWLEDGE, INFORMATION AND BELIEF THAT THIS PLAN FULLY AND ACCURATELY DEPICTS UNIT 57-24, THE LAYOUT OF THE UNIT, ITS LOCATION, DIMENSIONS, APPROXIMATE AREA, MAIN ENTRANCE AND IMMEDIATE COMMON AREA TO WHICH IT HAS ACCESS, AS BUILT

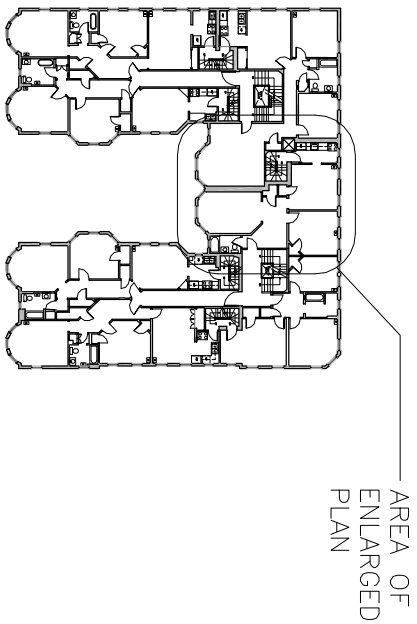

KEY PLAN

SCALE: 1" = 50'-0"

SECOND FLOOR PLAN (UNIT 57-24)

SCALE: 1/8" = 1'-0"

CRAMER & LEVINE ARCHITECTS
 134 EAST MAIN STREET
 TEL (508) 230-2466
 NORFOLK, MA 02766
 FAX (774) 265-1811

PROJECT: **57-59 MAGAZINE STREET CONDOMINIUM**
 57-59 MAGAZINE STREET
 CAMBRIDGE, MA 02139

DRAWN BY:	tm	NUMBER:	2-24
JOB #	04-072		
DATE:	1/3/06		
CAD FILE:			