


FIRST FLOOR PLAN (UNIT 57-3)
 SCALE: 1/8" = 1'-0"

I CERTIFY TO THE BEST OF MY KNOWLEDGE, INFORMATION AND BELIEF THAT THIS PLAN FULLY AND ACCURATELY DEPICTS UNIT 57-3, THE LAYOUT OF THE UNIT, ITS LOCATION, DIMENSIONS, APPROXIMATE AREA, MAIN ENTRANCE AND IMMEDIATE COMMON AREA TO WHICH IT HAS ACCESS, AS BUILT

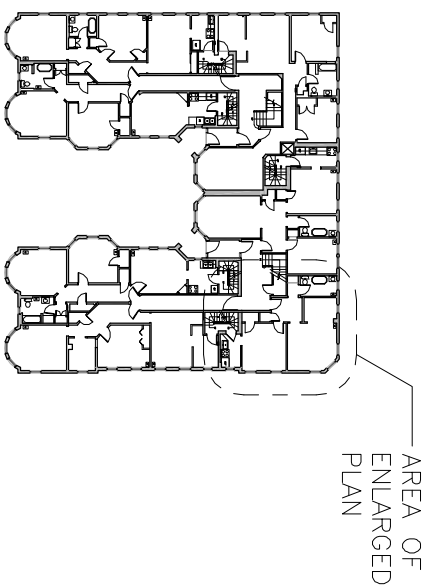

KEY PLAN

SCALE: 1" = 50'-0"

CRAMER & LEVINE
 ARCHITECTS
 134 EAST MAIN STREET
 NORTON, MA 02766
 TEL (508) 230-2466
 FAX (774) 265-1811

PROJECT:

**57-59 MAGAZINE STREET
 CONDOMINIUM
 57-59 MAGAZINE STREET
 CAMBRIDGE, MA 02139**

DRAWN BY:

tm

NUMBER:

1-3

JOB #

04-072

DATE:

1/3/06

CAD FILE: