


I CERTIFY TO THE BEST OF MY KNOWLEDGE, INFORMATION AND BELIEF THAT THIS PLAN FULLY AND ACCURATELY DEPICTS UNIT 57-4, THE LAYOUT OF THE UNIT, ITS LOCATION, DIMENSIONS, APPROXIMATE AREA, MAIN ENTRANCE AND IMMEDIATE COMMON AREA TO WHICH IT HAS ACCESS, AS BUILT

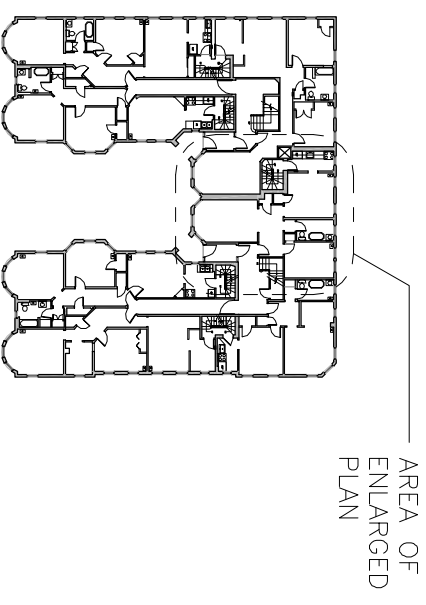

KEY PLAN

SCALE: 1" = 50'-0"

FIRST FLOOR PLAN (UNIT 57-4)

SCALE: 1/8" = 1'-0"



CRAMER & LEVINE

& C O M P A N Y
A R C H I T E C T S

134 EAST MAIN STREET
TEL (508) 230-2466
NORTON, MA 02766
FAX (774) 265-1811

PROJECT:

**57-59 MAGAZINE STREET
CONDOMINIUM**
**57-59 MAGAZINE STREET
CAMBRIDGE, MA 02139**

DRAWN BY:

tm

NUMBER:

JOB # 04-072

DATE: 1/3/06

CAD FILE:

