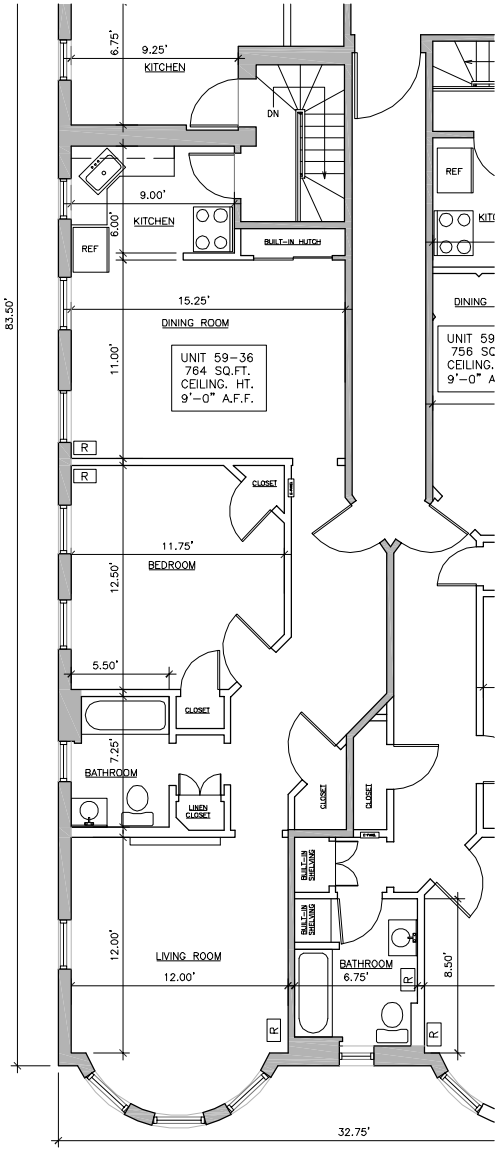

I CERTIFY TO THE BEST OF MY KNOWLEDGE, INFORMATION AND BELIEF THAT THIS PLAN FULLY AND ACCURATELY DEPICTS UNIT 59–36, THE LAYOUT OF THE UNIT, ITS LOCATION, DIMENSIONS, APPROXIMATE AREA, MAIN ENTRANCE AND IMMEDIATE COMMON AREA TO WHICH IT HAS ACCESS, AS BUILT

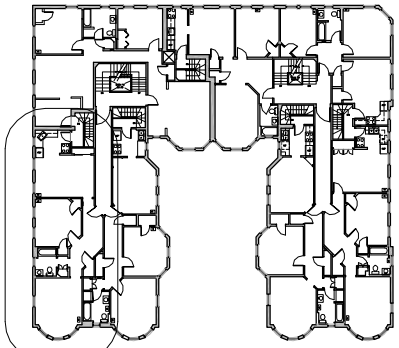

AREA OF ENLARGED PLAN

KEY PLAN

SCALE: 1"= 50'–0"

THIRD FLOOR PLAN (UNIT 59–36)

SCALE: 3/32"= 1'–0"

CRAMER ▪ LEVINE
& COMPANY
ARCHITECTS
134 EAST MAIN STREET NORTON, MA 02766
TEL (508) 230–2466 FAX (774) 265–1811

PROJECT:

57-59 MAGAZINE STREET CONDOMINIUM

57-59 MAGAZINE STREET
CAMBRIDGE, MA 02139

DRAWN BY: tm	NUMBER: 3–36
JOB # 04–072	
DATE: 1/3/06	
CAD FILE:	